

# ELEVATION CERTIFICATE

Important: Read the instructions on pages 1-9.

OMB No. 1660-0008  
 Expiration Date: July 31, 2015

## SECTION A - PROPERTY INFORMATION

FOR INSURANCE COMPANY USE

A1. Building Owner's Name STAPLETON, JIM & RANDALL, DOTTY

Policy Number:

A2. Building Street Address (including Apt., Unit, Suite, and/or Bldg. No.) or P.O. Route and Box No.  
 1739 NW HARVEY AVE

Company NAIC Number:

City ROSEBURG

State OR ZIP Code 97471

A3. Property Description (Lot and Block Numbers, Tax Parcel Number, Legal Description, etc.)  
 LOT 13, BLOCK 9, GARDEN HOMES, T.27S., R.06W, SEC. 14CA, TL 00200

A4. Building Use (e.g., Residential, Non-Residential, Addition, Accessory, etc.) RESIDENTIAL

A5. Latitude/Longitude: Lat. 43°13'18.85"N Long. 123°22'52.14"W

Horizontal Datum:  NAD 1927  NAD 1983

A6. Attach at least 2 photographs of the building if the Certificate is being used to obtain flood insurance.

A7. Building Diagram Number 4

A8. For a building with a crawlspace or enclosure(s):

- a) Square footage of crawlspace or enclosure(s) 760 sq ft
- b) Number of permanent flood openings in the crawlspace or enclosure(s) within 1.0 foot above adjacent grade 1
- c) Total net area of flood openings in A8.b 580 sq in
- d) Engineered flood openings?  Yes  No

A9. For a building with an attached garage:

- a) Square footage of attached garage 610 sq ft
- b) Number of permanent flood openings in the attached garage within 1.0 foot above adjacent grade 0
- c) Total net area of flood openings in A9.b 0 sq in
- d) Engineered flood openings?  Yes  No

## SECTION B - FLOOD INSURANCE RATE MAP (FIRM) INFORMATION

B1. NFIP Community Name & Community Number  
 ROSEBURG, CITY OF/410067

B2. County Name  
 DOUGLAS

B3. State  
 OREGON

B4. Map/Panel Number  
 41019C 1707

B5. Suffix  
 F

B6. FIRM Index Date  
 17 FEB 2010

B7. FIRM Panel Effective/Revised Date  
 17 FEB 2010

B8. Flood Zone(s)  
 AE

B9. Base Flood Elevation(s) (Zone AO, use base flood depth)  
 437.2

B10. Indicate the source of the Base Flood Elevation (BFE) data or base flood depth entered in Item B9.

- FIS Profile  FIRM  Community Determined  Other/Source: \_\_\_\_\_

B11. Indicate elevation datum used for BFE in Item B9:  NGVD 1929  NAVD 1988  Other/Source: \_\_\_\_\_

B12. Is the building located in a Coastal Barrier Resources System (CBRS) area or Otherwise Protected Area (OPA)?  Yes  No  
 Designation Date: N/A  CBRS  OPA

## SECTION C - BUILDING ELEVATION INFORMATION (SURVEY REQUIRED)

C1. Building elevations are based on:  Construction Drawings\*  Building Under Construction\*  Finished Construction

\*A new Elevation Certificate will be required when construction of the building is complete.

C2. Elevations - Zones A1-A30, AE, AH, A (with BFE), VE, V1-V30, V (with BFE), AR, AR/A, AR/AE, AR/A1-A30, AR/AH, AR/AO. Complete Items C2.a-h below according to the building diagram specified in Item A7. In Puerto Rico only, enter meters.

Benchmark Utilized: VAJDA Vertical Datum: 437.638

Indicate elevation datum used for the elevations in items a) through h) below.  NGVD 1929  NAVD 1988  Other/Source: \_\_\_\_\_

Datum used for building elevations must be the same as that used for the BFE.

Check the measurement used.

- a) Top of bottom floor (including basement, crawlspace, or enclosure floor) 432.5  feet  meters
- b) Top of the next higher floor 439.2  feet  meters
- c) Bottom of the lowest horizontal structural member (V Zones only) N/A  feet  meters
- d) Attached garage (top of slab) 434.5  feet  meters
- e) Lowest elevation of machinery or equipment servicing the building (Describe type of equipment and location in Comments) 435.1  feet  meters
- f) Lowest adjacent (finished) grade next to building (LAG) 432.5  feet  meters
- g) Highest adjacent (finished) grade next to building (HAG) 435.5  feet  meters
- h) Lowest adjacent grade at lowest elevation of deck or stairs, including structural support 432.5  feet  meters

## SECTION D - SURVEYOR, ENGINEER, OR ARCHITECT CERTIFICATION

This certification is to be signed and sealed by a land surveyor, engineer, or architect authorized by law to certify elevation information. I certify that the information on this Certificate represents my best efforts to interpret the data available. I understand that any false statement may be punishable by fine or imprisonment under 18 U.S. Code, Section 1001.

- Check here if comments are provided on back of form. Were latitude and longitude in Section A provided by a licensed land surveyor?  Yes  No
- Check here if attachments.

Certifier's Name MICHAEL P. SCHULZE

License Number 71827

Title PROF. LAND SURVEYOR

Company Name AA SURVEYING & ASSOCIATES, INC.

Address 3076 NE DIAMOND LAKE BLVD

City ROSEBURG

State OR ZIP Code 97470

Signature *Michael P. Schulze*

Date 8/28/2014

Telephone 541-672-2096

REGISTERED  
 PROFESSIONAL  
 LAND SURVEYOR

OREGON  
 NOVEMBER 30, 2007  
 MICHAEL P. SCHULZE  
 71827

EXP. DATE: 6/30/16

**ELEVATION CERTIFICATE, page 2**

<b>IMPORTANT: In these spaces, copy the corresponding information from Section A.</b>	<b>FOR INSURANCE COMPANY USE</b>
Building Street Address (including Apt., Unit, Suite, and/or Bldg. No.) or P.O. Route and Box No. 1739 NW HARVEY AVE	Policy Number:
City ROSEBURG State OR ZIP Code 97471	Company NAIC Number:

**SECTION D – SURVEYOR, ENGINEER, OR ARCHITECT CERTIFICATION (CONTINUED)**

Copy both sides of this Elevation Certificate for (1) community official, (2) insurance agent/company, and (3) building owner.

Comments C2e - HEAT PUMP

Signature _____	Date _____
-----------------	------------

**SECTION E – BUILDING ELEVATION INFORMATION (SURVEY NOT REQUIRED) FOR ZONE AO AND ZONE A (WITHOUT BFE)**

For Zones AO and A (without BFE), complete Items E1–E5. If the Certificate is intended to support a LOMA or LOMR-F request, complete Sections A, B, and C. For Items E1–E4, use natural grade, if available. Check the measurement used. In Puerto Rico only, enter meters.

- E1. Provide elevation information for the following and check the appropriate boxes to show whether the elevation is above or below the highest adjacent grade (HAG) and the lowest adjacent grade (LAG).
  - a) Top of bottom floor (including basement, crawlspace, or enclosure) is \_\_\_\_\_  feet  meters  above or  below the HAG.
  - b) Top of bottom floor (including basement, crawlspace, or enclosure) is \_\_\_\_\_  feet  meters  above or  below the LAG.
- E2. For Building Diagrams 6–9 with permanent flood openings provided in Section A Items 8 and/or 9 (see pages 8–9 of Instructions), the next higher floor (elevation C2.b in the diagrams) of the building is \_\_\_\_\_  feet  meters  above or  below the HAG.
- E3. Attached garage (top of slab) is \_\_\_\_\_  feet  meters  above or  below the HAG.
- E4. Top of platform of machinery and/or equipment servicing the building is \_\_\_\_\_  feet  meters  above or  below the HAG.
- E5. Zone AO only: If no flood depth number is available, is the top of the bottom floor elevated in accordance with the community's floodplain management ordinance?  Yes  No  Unknown. The local official must certify this information in Section G.

**SECTION F – PROPERTY OWNER (OR OWNER'S REPRESENTATIVE) CERTIFICATION**

The property owner or owner's authorized representative who completes Sections A, B, and E for Zone A (without a FEMA-issued or community-issued BFE) or Zone AO must sign here. The statements in Sections A, B, and E are correct to the best of my knowledge.

Property Owner's or Owner's Authorized Representative's Name \_\_\_\_\_

Address _____	City _____	State _____	ZIP Code _____
Signature _____	Date _____	Telephone _____	

Comments \_\_\_\_\_

Check here if attachments.

**SECTION G – COMMUNITY INFORMATION (OPTIONAL)**

The local official who is authorized by law or ordinance to administer the community's floodplain management ordinance can complete Sections A, B, C (or E), and G of this Elevation Certificate. Complete the applicable item(s) and sign below. Check the measurement used in Items G8–G10. In Puerto Rico only, enter meters.

- G1.  The information in Section C was taken from other documentation that has been signed and sealed by a licensed surveyor, engineer, or architect who is authorized by law to certify elevation information. (Indicate the source and date of the elevation data in the Comments area below.)
- G2.  A community official completed Section E for a building located in Zone A (without a FEMA-issued or community-issued BFE) or Zone AO.
- G3.  The following information (Items G4–G10) is provided for community floodplain management purposes.

G4. Permit Number _____	G5. Date Permit Issued _____	G6. Date Certificate Of Compliance/Occupancy Issued _____
-------------------------	------------------------------	---

- G7. This permit has been issued for:  New Construction  Substantial Improvement
- G8. Elevation of as-built lowest floor (including basement) of the building: \_\_\_\_\_  feet  meters Datum \_\_\_\_\_
- G9. BFE or (in Zone AO) depth of flooding at the building site: \_\_\_\_\_  feet  meters Datum \_\_\_\_\_
- G10. Community's design flood elevation: \_\_\_\_\_  feet  meters Datum \_\_\_\_\_

Local Official's Name _____	Title _____
Community Name _____	Telephone _____
Signature _____	Date _____

Comments \_\_\_\_\_

Check here if attachments.

# Building Photographs

See Instructions for Item A6.

**IMPORTANT: In these spaces, copy the corresponding information from Section A.**

Building Street Address (including Apt., Unit, Suite, and/or Bldg. No.) or P.O. Route and Box No.  
1739 NW HARVEY AVE

City ROSEBURG

 
State OR ZIP Code 97471

FOR INSURANCE COMPANY USE

Policy Number:

Company NAIC Number:

If using the Elevation Certificate to obtain NFIP flood insurance, affix at least 2 building photographs below according to the instructions for Item A6. Identify all photographs with date taken; "Front View" and "Rear View"; and, if required, "Right Side View" and "Left Side View." When applicable, photographs must show the foundation with representative examples of the flood openings or vents, as indicated in Section A8. If submitting more photographs than will fit on this page, use the Continuation Page.



# Building Photographs

Continuation Page

**IMPORTANT: In these spaces, copy the corresponding information from Section A.**

FOR INSURANCE COMPANY USE

Building Street Address (including Apt., Unit, Suite, and/or Bldg. No.) or P.O. Route and Box No.  
1739 NW HARVEY AVE

Policy Number:

City ROSEBURG

State OR ZIP Code 97471

Company NAIC Number:

If submitting more photographs than will fit on the preceding page, affix the additional photographs below. Identify all photographs with: date taken; "Front View" and "Rear View"; and, if required, "Right Side View" and "Left Side View." When applicable, photographs must show the foundation with representative examples of the flood openings or vents, as indicated in Section A8.




Form 6-2013

**FLOODPLAIN BUILDING SITE DIAGRAM** (To be completed by an Oregon Licensed Surveyor or Engineer)

PROPERTY I.D. NO. R 67420 WORK SHEET NO. 1  
 TOWNSHIP 27S RANGE 06W SEC. 14 SUB SEC. CA TAX LOT NO. 00200  
 TOWNSHIP \_\_\_\_\_ RANGE \_\_\_\_\_ SEC. \_\_\_\_\_ SUB SEC. \_\_\_\_\_ TAX LOT NO. \_\_\_\_\_

**INFORMATION NEEDED ON DIAGRAM**

1. Approximate property lines (show dimensions).
2. Permanent land marks (roads, streams, rivers).
3. Distances from landmarks to building site.
4. Put stakes at building site (one flagged stake in middle of the site is sufficient).
5. Temporary bench mark established at 100 year flood elevation.
6. Location of floodway on site.

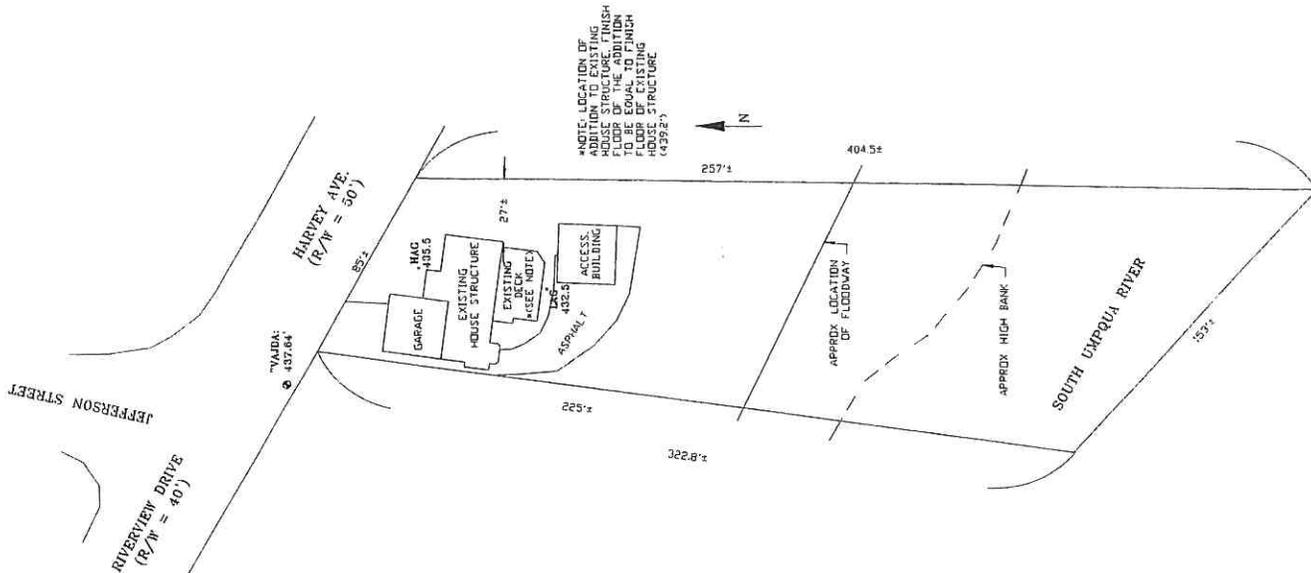

THIS FORM IS FOR THE PURPOSE OF AN ADDITION TO BE ADDED TO THE EXISTING HOUSE STRUCTURE. NO TBM WAS SET, BECAUSE OF THE CLOSE PROXIMITY OF THE BM AND BECAUSE THE ADDITION IS TO MATCH THE FINISH FLOOR OF THE EXISTING STRUCTURE (439.2')

**PART ONE PRE-CONSTRUCTION**

BM NO: V-018 "VALDA"		BM ELEVATION: 437.64		BM LOCATION: Intersection of RIVERVIEW DR. & JEFFERSON ST.		100 YEAR BASE FLOOD ELEVATION: 437.2	
Elevation datum NAVD 88 YES		TBM ELEVATION: N/A		TBM LOCATION: N/A		TBM DESCRIPTION: N/A	
FEDERAL 100 YEAR	Yes	FEDERAL FLOODWAY	Yes	MEAN FLOODWAY VELOCITY: 10.3 FT/SEC	EXTREME HAZARD	HIGH HAZARD	LOW HAZARD
	No		No				
FIRM MAP PANEL: Map: 41019C Panel: 1707F		BUILDING SITE ELEVATION: 432.5'		Residential: MINIMUM REQUIRED FLOOR HEIGHT ABOVE GROUND TO BE 1' ABOVE BFE:		438.2	
				Manufactured Home: MINIMUM REQUIRED FLOOR HEIGHT ABOVE GROUND TO BE 18" ABOVE BFE:		N/A	
Insurance Implication: Construction or placement of structures elevated less than 1' above BFE may result in increased premium rates for flood insurance, and such construction below the BFE increases risks to life and property.				Non-residential: FLOOR HEIGHT TO BFE OR ABOVE:		N/A	
				Exempt non-residential: FLOODPROOFING HEIGHT TO BFE OR ABOVE:		N/A	

I certify as an Oregon Registered Professional Engineer or Surveyor that the above information is true and accurate.

SIGNATURE Michael B. [Signature] DATE 8-28-14


**PART TWO POST-CONSTRUCTION** (Part One must also be completed on this form)


The building at the property location described above has the lowest floor (including basement, if any) at an elevation of:	feet NGVD (Mean Sea Level):	The reference level is based on actual construction.	
or has been floodproofed in accordance with the Floodplain Ordinance to an elevation of:	feet NGVD (Mean Sea Level):	Yes	No

I certify as an Oregon Registered Professional Engineer or Surveyor that the above information is true and accurate.

SIGNATURE \_\_\_\_\_ DATE \_\_\_\_\_

09/16/2014, 10:23

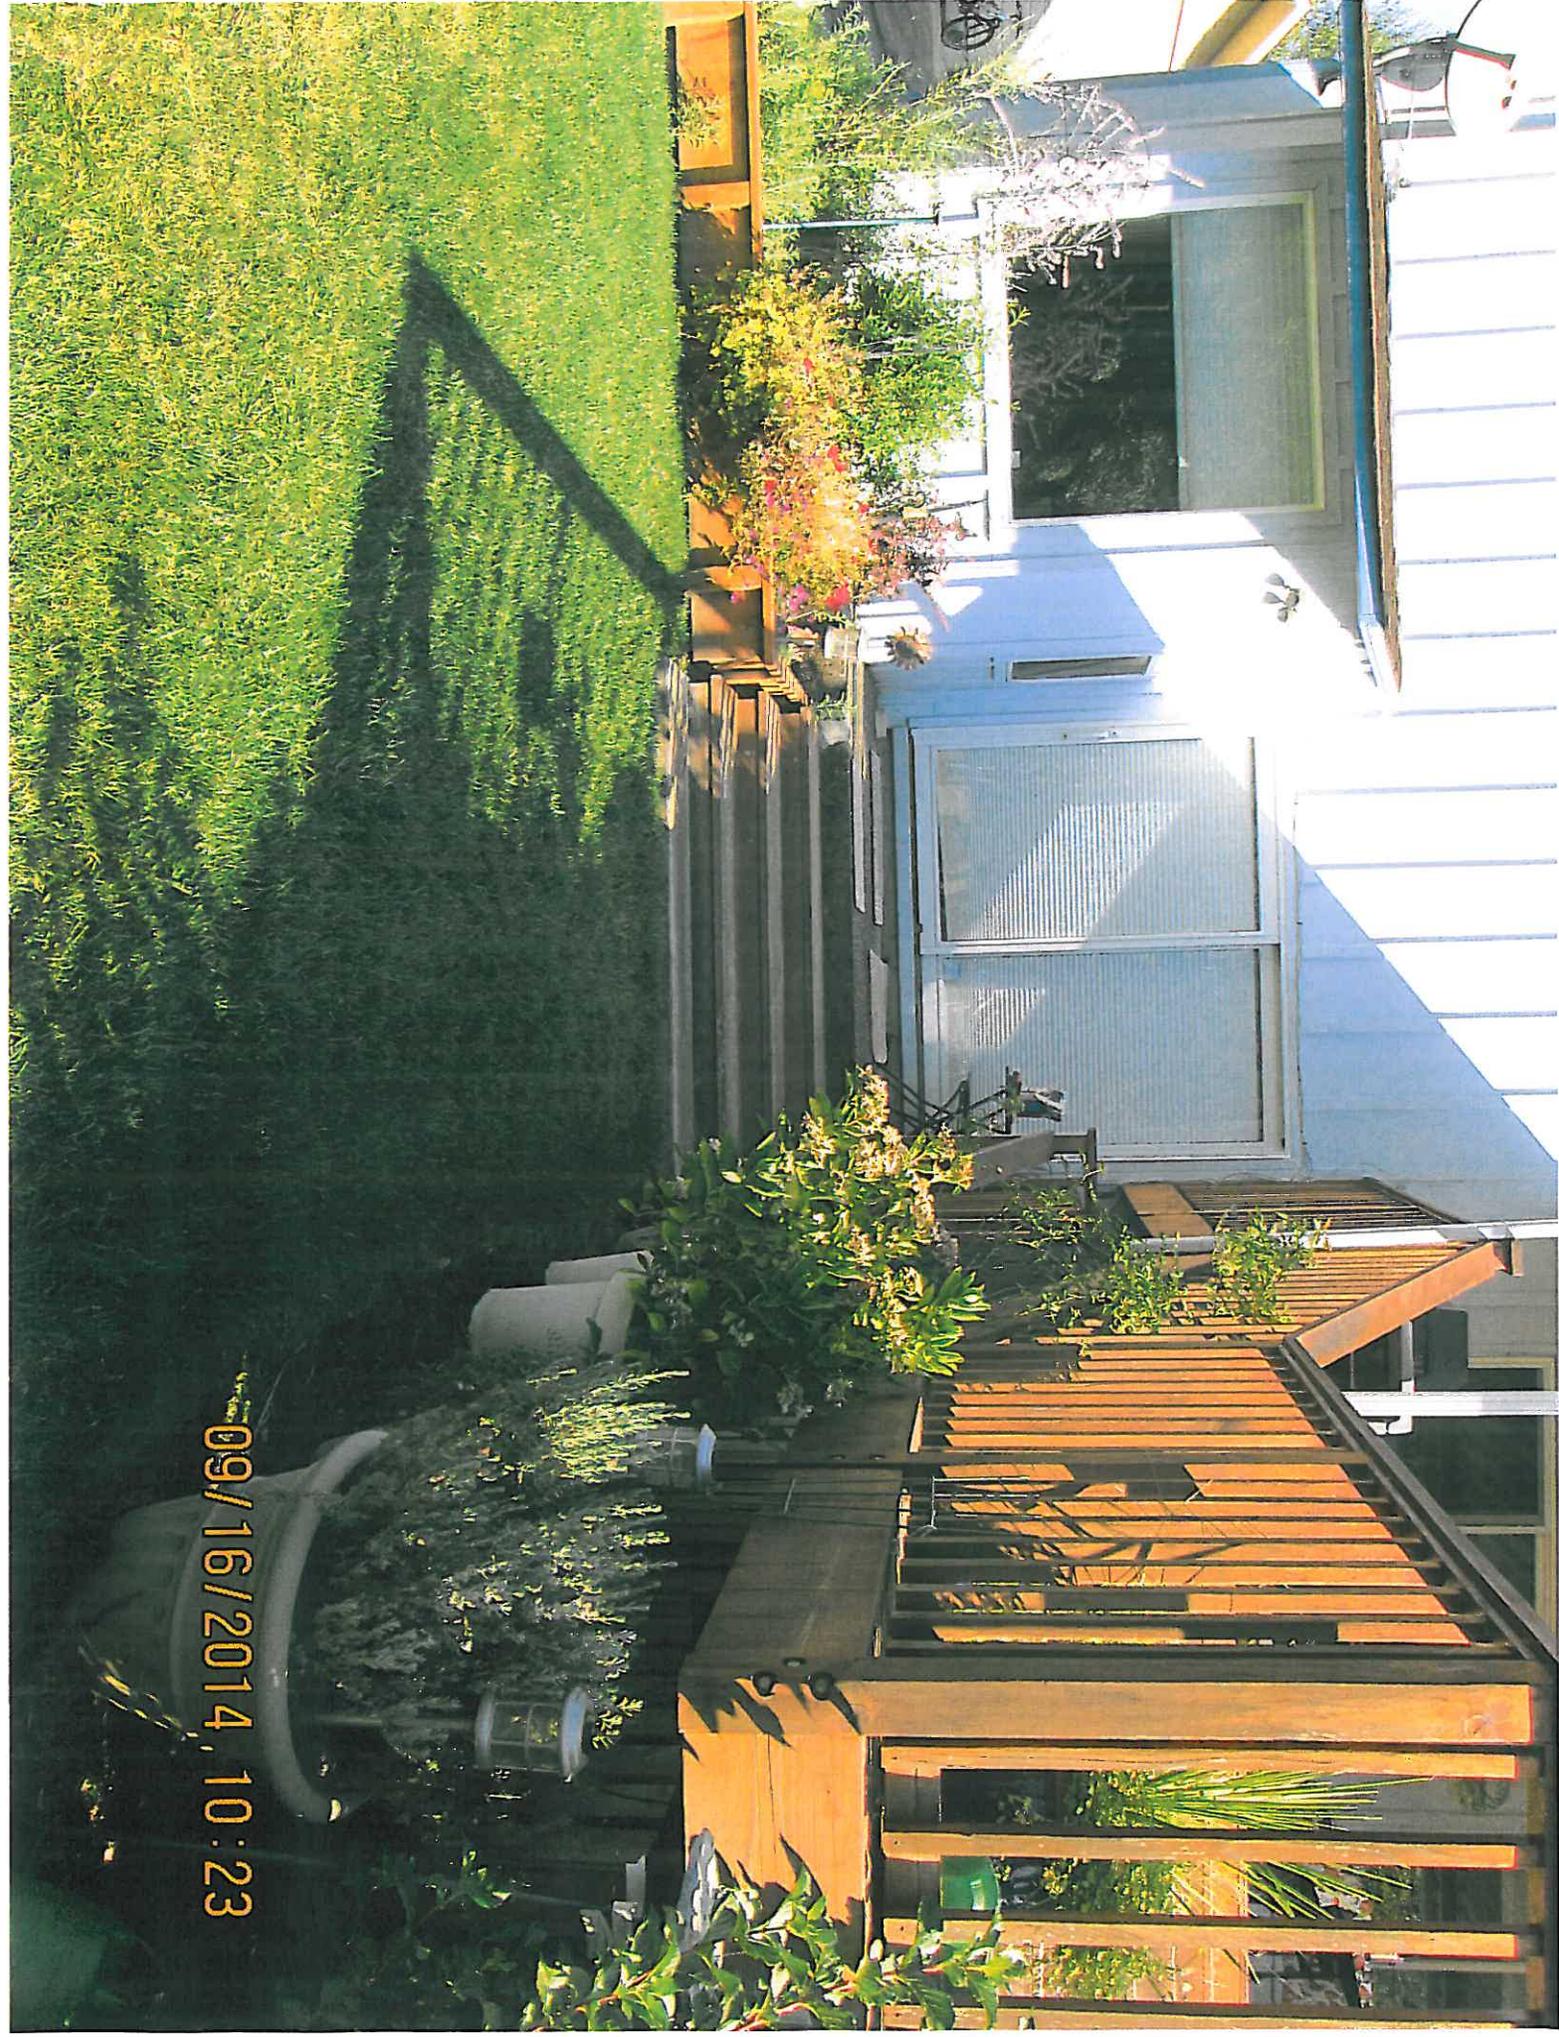

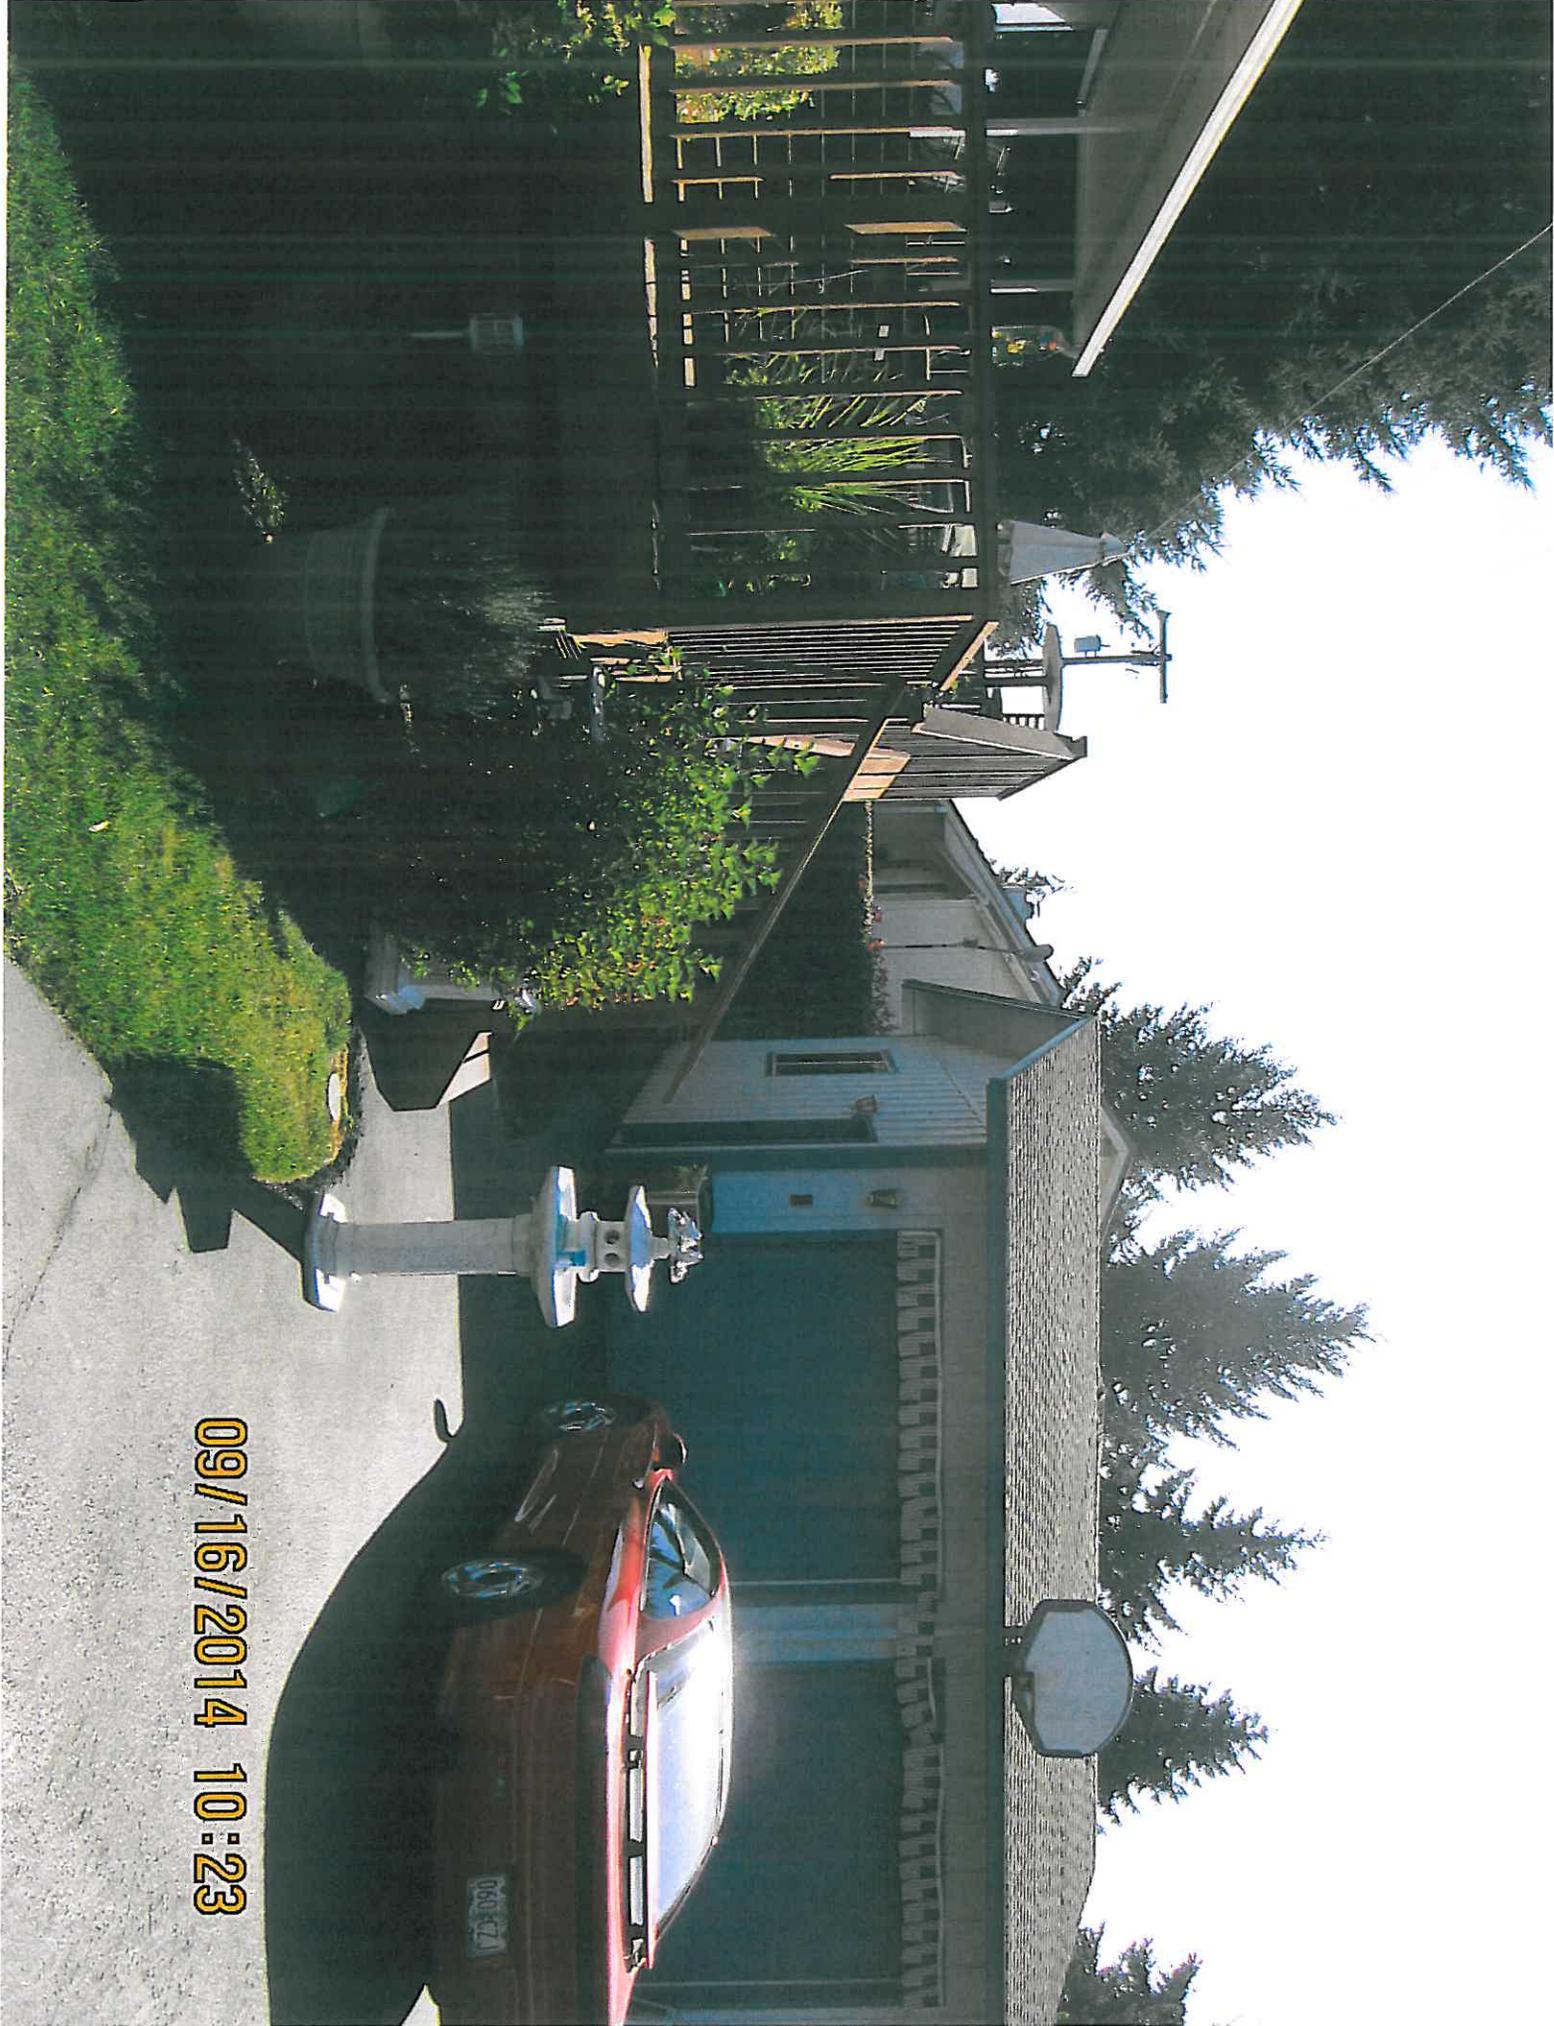

09/16/2014 10:23