

FEDERAL EMERGENCY MANAGEMENT AGENCY
NATIONAL FLOOD INSURANCE PROGRAM

O.M.B. No. 3067-0077
Expires July 31, 2002

ELEVATION CERTIFICATE

Important: Read the instructions on pages 1 - 7.

SECTION A - PROPERTY OWNER INFORMATION			For Insurance Company Use:
BUILDING OWNER'S NAME Tim Blanchard		Policy Number	
BUILDING STREET ADDRESS (Including Apt., Unit, Suite, and/or Bldg. No.) OR P.O. ROUTE AND BOX NO. 3003 NE Douglas		Company NAIC Number	
CITY Roseburg	STATE OR	ZIP CODE 97470	
PROPERTY DESCRIPTION (Lot and Block Numbers, Tax Parcel Number, Legal Description, etc.) Tax Lot 1800, Section 20AC, T27S, R5W,WM			
BUILDING USE (e.g., Residential, Non-residential, Addition, Accessory, etc. Use a Comments area, if necessary.) Residential			
LATITUDE/LONGITUDE (OPTIONAL) (##° - ##' - ##.###" or ###.#####")		HORIZONTAL DATUM: <input type="checkbox"/> NAD 1927 <input type="checkbox"/> NAD 1983	SOURCE: <input type="checkbox"/> GPS (Type): _____ <input type="checkbox"/> USGS Quad Map <input type="checkbox"/> Other: _____

SECTION B - FLOOD INSURANCE RATE MAP (FIRM) INFORMATION

B1. NFIP COMMUNITY NAME & COMMUNITY NUMBER 4100067		B2. COUNTY NAME Douglas		B3. STATE OR	
B4. MAP AND PANEL NUMBER 0005	B5. SUFFIX E	B6. FIRM INDEX DATE	B7. FIRM PANEL EFFECTIVE/REVISED DATE 1999-4-21	B8. FLOOD ZONE(S) A3	B9. BASE FLOOD ELEVATION(S) (Zone AO, use depth of flooding) 474.8

B10. Indicate the source of the Base Flood Elevation (BFE) data or base flood depth entered in B9.
 FIS Profile FIRM Community Determined Other (Describe): _____
 NAVD 1988 Other (Describe): _____

B11. Indicate the elevation datum used for the BFE in B9: NGVD 1929

B12. Is the building located in a Coastal Barrier Resources System (CBRS) area or Otherwise Protected Area (OPA)? Yes No Designation Date _____

SECTION C - BUILDING ELEVATION INFORMATION (SURVEY REQUIRED)

C1. Building elevations are based on: Construction Drawings* Building Under Construction* Finished Construction
 *A new Elevation Certificate will be required when construction of the building is complete.

C2. Building Diagram Number 8 (Select the building diagram most similar to the building for which this certificate is being completed - see pages 6 and 7. If no diagram accurately represents the building, provide a sketch or photograph.)

C3. Elevations - Zones A1-A30, AE, AH, A (with BFE), VE, V1-V30, V (with BFE), AR, AR/A, AR/AE, AR/A1-A30, AR/AH, AR/AO
 Complete Items C3-a-i below according to the building diagram specified in Item C2. State the datum used. If the datum is different from the datum used for the BFE in Section B, convert the datum to that used for the BFE. Show field measurements and datum conversion calculation. Use the space provided or the Comments area of Section D or Section G, as appropriate, to document the datum conversion.
 Datum _____ Conversion/Comments _____

Elevation reference mark used ** Does the elevation reference mark used appear on the FIRM? Yes No

a) Top of bottom floor (including basement or enclosure) 474.8 ft.(m)
 b) Top of next higher floor 478.0 ft.(m)
 c) Bottom of lowest horizontal structural member (V zones only) NA. ft.(m)
 d) Attached garage (top of slab) NA. ft.(m)
 e) Lowest elevation of machinery and/or equipment servicing the building (Describe in a Comments area) NA. ft.(m)
 f) Lowest adjacent (finished) grade (LAG) NA. ft.(m)
 g) Highest adjacent (finished) grade (HAG) NA. ft.(m)
 h) No. of permanent openings (flood vents) within 1 ft. above adjacent grade 29
 i) Total area of all permanent openings (flood vents) in C3.h 870 sq. in. (sq. cm)



SECTION D - SURVEYOR, ENGINEER, OR ARCHITECT CERTIFICATION

This certification is to be signed and sealed by a land surveyor, engineer, or architect authorized by law to certify elevation information.
 I certify that the information in Sections A, B, and C on this certificate represents my best efforts to interpret the data available.
 I understand that any false statement may be punishable by fine or imprisonment under 18 U.S. Code, Section 1001.

CERTIFIER'S NAME Maurice E Farr LICENSE NUMBER Ore PE 5188

TITLE Professional Engineer	COMPANY NAME Maurice E Farr Professional Engineer		
ADDRESS 395 NE Kirby Avenue	CITY Roseburg	STATE OR	ZIP CODE 97470
SIGNATURE Maurice E Farr	DATE 2002-06-13 2002-06-13	TELEPHONE 541 957 9442	

IMPORTANT: In these spaces, copy the corresponding information from Section A.			For Insurance Company Use
BUILDING STREET ADDRESS (including Apt., Unit, Suite, and/or Bldg. No.) OR P.O. ROUTE AND BOX NO. 3003 NE Douglas			Policy Number
CITY Roseburg	STATE OR	ZIP CODE 97470	Company NAIC Number

SECTION D - SURVEYOR, ENGINEER, OR ARCHITECT CERTIFICATION (CONTINUED)

Copy both sides of this Elevation Certificate for (1) community official, (2) insurance agent/company, and (3) building owner.

COMMENTS

The finished floor elevation of this existing house is 3.2 feet above the 100 year flood.

** Roseburg 5 Elevation 472.20'

Check here if attachments

SECTION E - BUILDING ELEVATION INFORMATION (SURVEY NOT REQUIRED) FOR ZONE AO AND ZONE A (WITHOUT BFE)

For Zone AO and Zone A (without BFE), complete Items E1 through E4. If the Elevation Certificate is intended for use as supporting information for a LOMA or LOMR-F, Section C must be completed.

- E1. Building Diagram Number __ (Select the building diagram most similar to the building for which this certificate is being completed – see pages 6 and 7. If no diagram accurately represents the building, provide a sketch or photograph.)
- E2. The top of the bottom floor (including basement or enclosure) of the building is __ ft.(m) __ in.(cm) above or below (check one) the highest adjacent grade. (Use natural grade, if available).
- E3. For Building Diagrams 6-8 with openings (see page 7), the next higher floor or elevated floor (elevation b) of the building is __ ft.(m) __ in.(cm) above the highest adjacent grade. Complete items C3.h and C3.i on front of form.
- E4. For Zone AO only: If no flood depth number is available, is the top of the bottom floor elevated in accordance with the community's floodplain management ordinance?
 Yes No Unknown. The local official must certify this information in Section G.

SECTION F - PROPERTY OWNER (OR OWNER'S REPRESENTATIVE) CERTIFICATION

The property owner or owner's authorized representative who completes Sections A, B, C (Items C3.h and C3.i only), and E for Zone A (without a FEMA-issued or community-issued BFE) or Zone AO must sign here. The statements in Sections A, B, C, and E are correct to the best of my knowledge.

PROPERTY OWNER'S OR OWNER'S AUTHORIZED REPRESENTATIVE'S NAME

ADDRESS	CITY	STATE	ZIP CODE
SIGNATURE	DATE	TELEPHONE	

COMMENTS

Check here if attachments

SECTION G - COMMUNITY INFORMATION (OPTIONAL)

The local official who is authorized by law or ordinance to administer the community's floodplain management ordinance can complete Sections A, B, C (or E), and G of this Elevation Certificate. Complete the applicable item(s) and sign below.

- G1. The information in Section C was taken from other documentation that has been signed and embossed by a licensed surveyor, engineer, or architect who is authorized by state or local law to certify elevation information. (Indicate the source and date of the elevation data in the Comments area below.)
- G2. A community official completed Section E for a building located in Zone A (without a FEMA-issued or community-issued BFE) or Zone AO.
- G3. The following information (Items G4-G9) is provided for community floodplain management purposes.

G4. PERMIT NUMBER	G5. DATE PERMIT ISSUED	G6. DATE CERTIFICATE OF COMPLIANCE/OCCUPANCY ISSUED
-------------------	------------------------	---

G7. This permit has been issued for: New Construction Substantial Improvement

G8. Elevation of as-built lowest floor (including basement) of the building is: _____ ft.(m) Datum: _____

G9. BFE or (in Zone AO) depth of flooding at the building site is: _____ ft.(m) Datum: _____

LOCAL OFFICIAL'S NAME _____ TITLE _____

COMMUNITY NAME _____ TELEPHONE _____

SIGNATURE _____ DATE _____

COMMENTS

Check here if attachments

FLOODPLAIN BUILDING SITE DIAGRAM

(To be completed by an Oregon Licensed Surveyor or Engineer.)


WORK SHEET NO. _____

TAX ACCT. NO. _____ TAX LOT NO. 1800 SEC. 20 SUB SEC. _____ AC _____ TOWNSHIP 27 S RANGE 5 W WM _____

DIRECTIONS TO AND DESCRIPTION OF SITE: From intersection of Diamond Lake Blvd and Patterson, drive south on Patterson Street to NE Douglas Street, turn left on NE Douglas 80 ft to the project site on the right.

INFORMATION NEEDED ON DIAGRAM

1. Approximate property lines (show dimensions).
2. Permanent land marks (roads, streams, rivers).
3. Distances from landmarks to building site.
4. Put stakes at building site (one flagged stake in middle of the site is sufficient).
5. Temporary bench mark established at 100 year flood elevation.
6. Location of floodway on site.

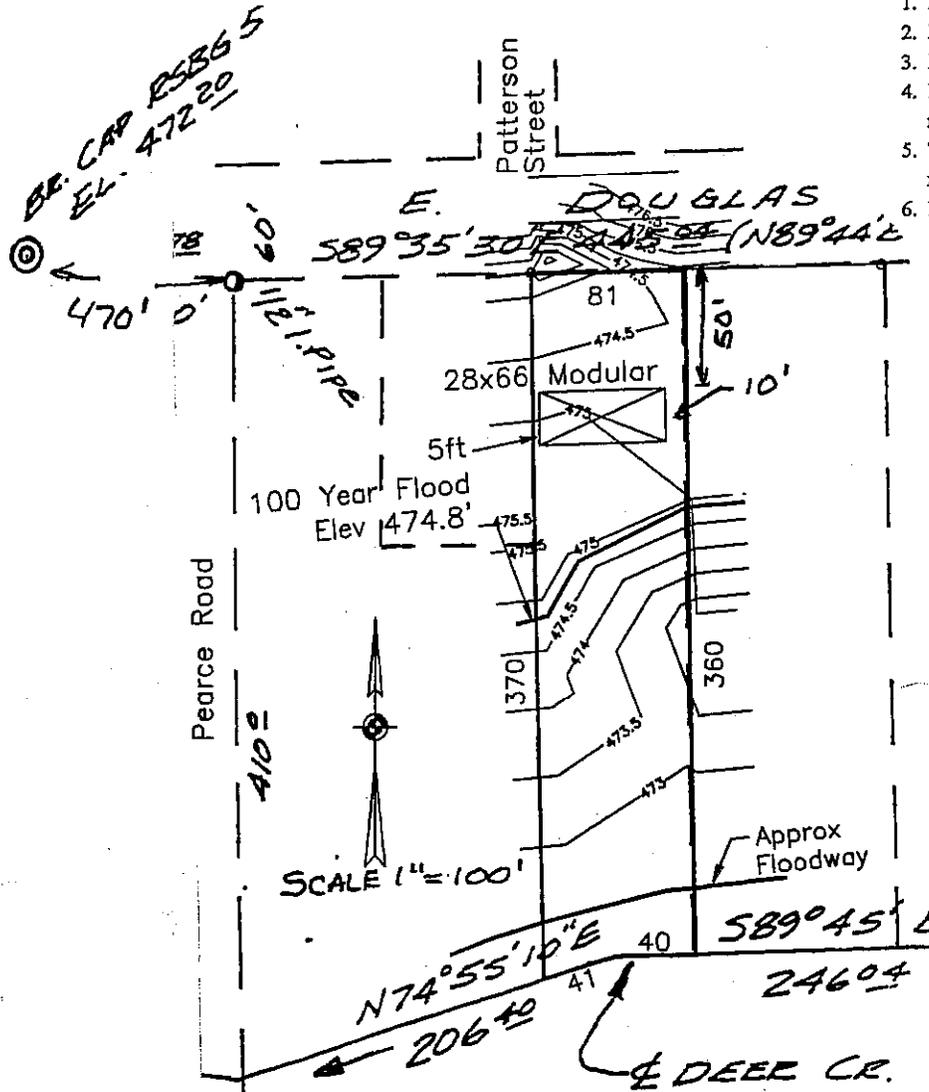

** Brass Cap Rsbgr 5 Elev 472.20

PART ONE PRE-CONSTRUCTION

BM: NO **_ELEVATION**_LOCATION_ see map_ 100 YEAR FLOOD ELEV. 474.8 (NOTE: Elevation datum MSL)
 TBM ELEVATION Not Set LOCATION N/A TBM DESCRIPTION RSBG 5 BM IS CLOSE ENOUGH
 [FEDERAL 100 YEAR YES NO] [FEDERAL FLOODWAY YES NO] [MEAN FLOODWAY VELOCITY N/A]
 EXTREME HAZARD HIGH HAZARD LOW HAZARD BUILDING SITE ELEVATION 475
 FLOODWAY MAP _____ ORTHO PHOTO _____ MINIMUM REQUIRED FLOOR HEIGHT ABOVE GROUND 2.0'

PART TWO POST-CONSTRUCTION

The building at the property location described above has the lowest floor (including basement) at an elevation of _____ feet NGVD (Mean Sea Level) or has been flood proofed in accordance with the Flood plain Ordinance to an elevation of _____ feet NGVD. The reference level is based on actual construction. YES NO

I CERTIFY AS AN OREGON REGISTERED PROFESSIONAL ENGINEER/SURVEYOR THAT THE ABOVE INFORMATION IS TRUE AND ACCURATE.

DATE _____ SIGNATURE _____

(REVISED 10/99)